


New Layout.



NORTH

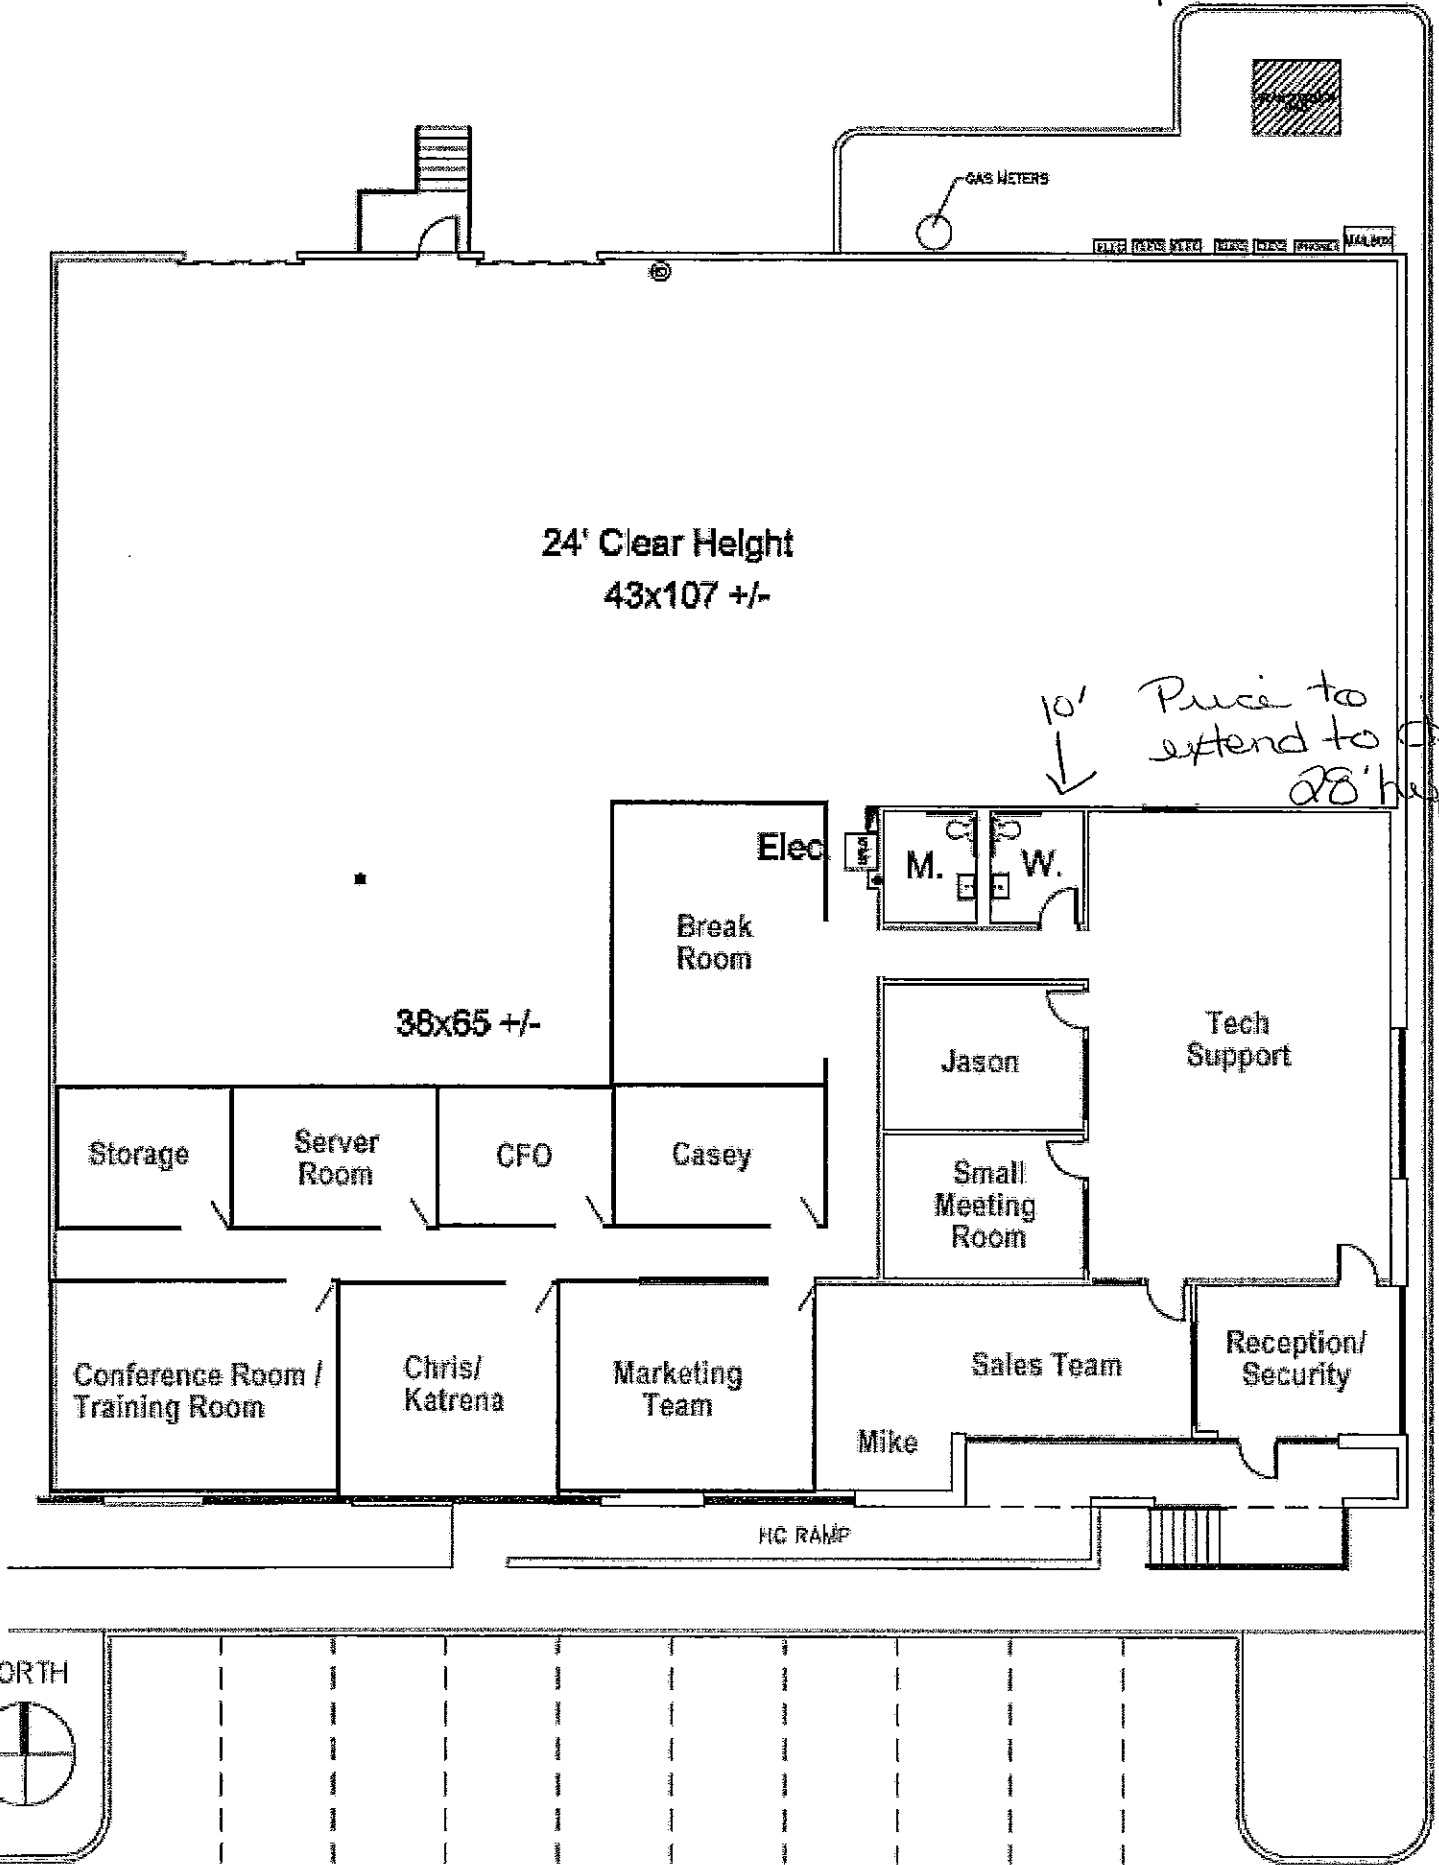


# 1501 10<sup>th</sup> Ave - Suite 150

Plano, Texas 75074


AS Built

SPACE PLAN

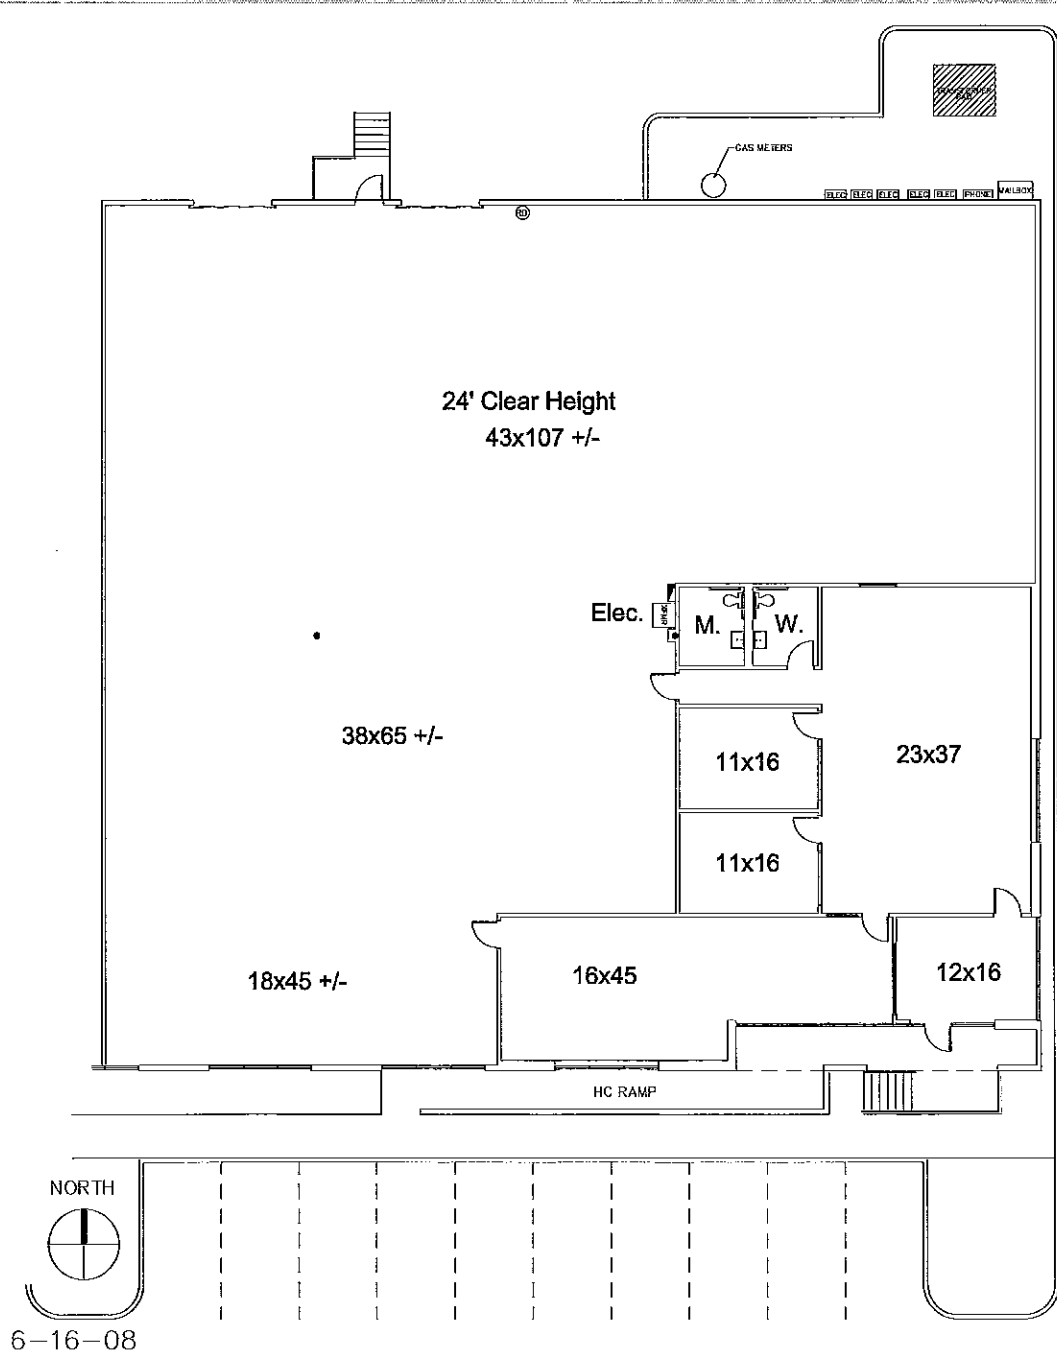

10,800 S.F. Total / 2,705 S. F. Office Area

For further information call:  
First Industrial Realty Trust, Inc.  
4505 Excel Parkway, Suite 600 Addison, Texas 75001  
(972) 386-4700 phone (972) 386-4540 facsimile  
[www.firstindustrial.com](http://www.firstindustrial.com)

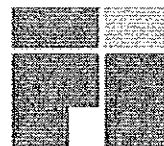

**FIRST**  
INDUSTRIAL  
REALTY TRUST