©COPYRIGHT 2005 – ALLIANCE ARCHITECTS

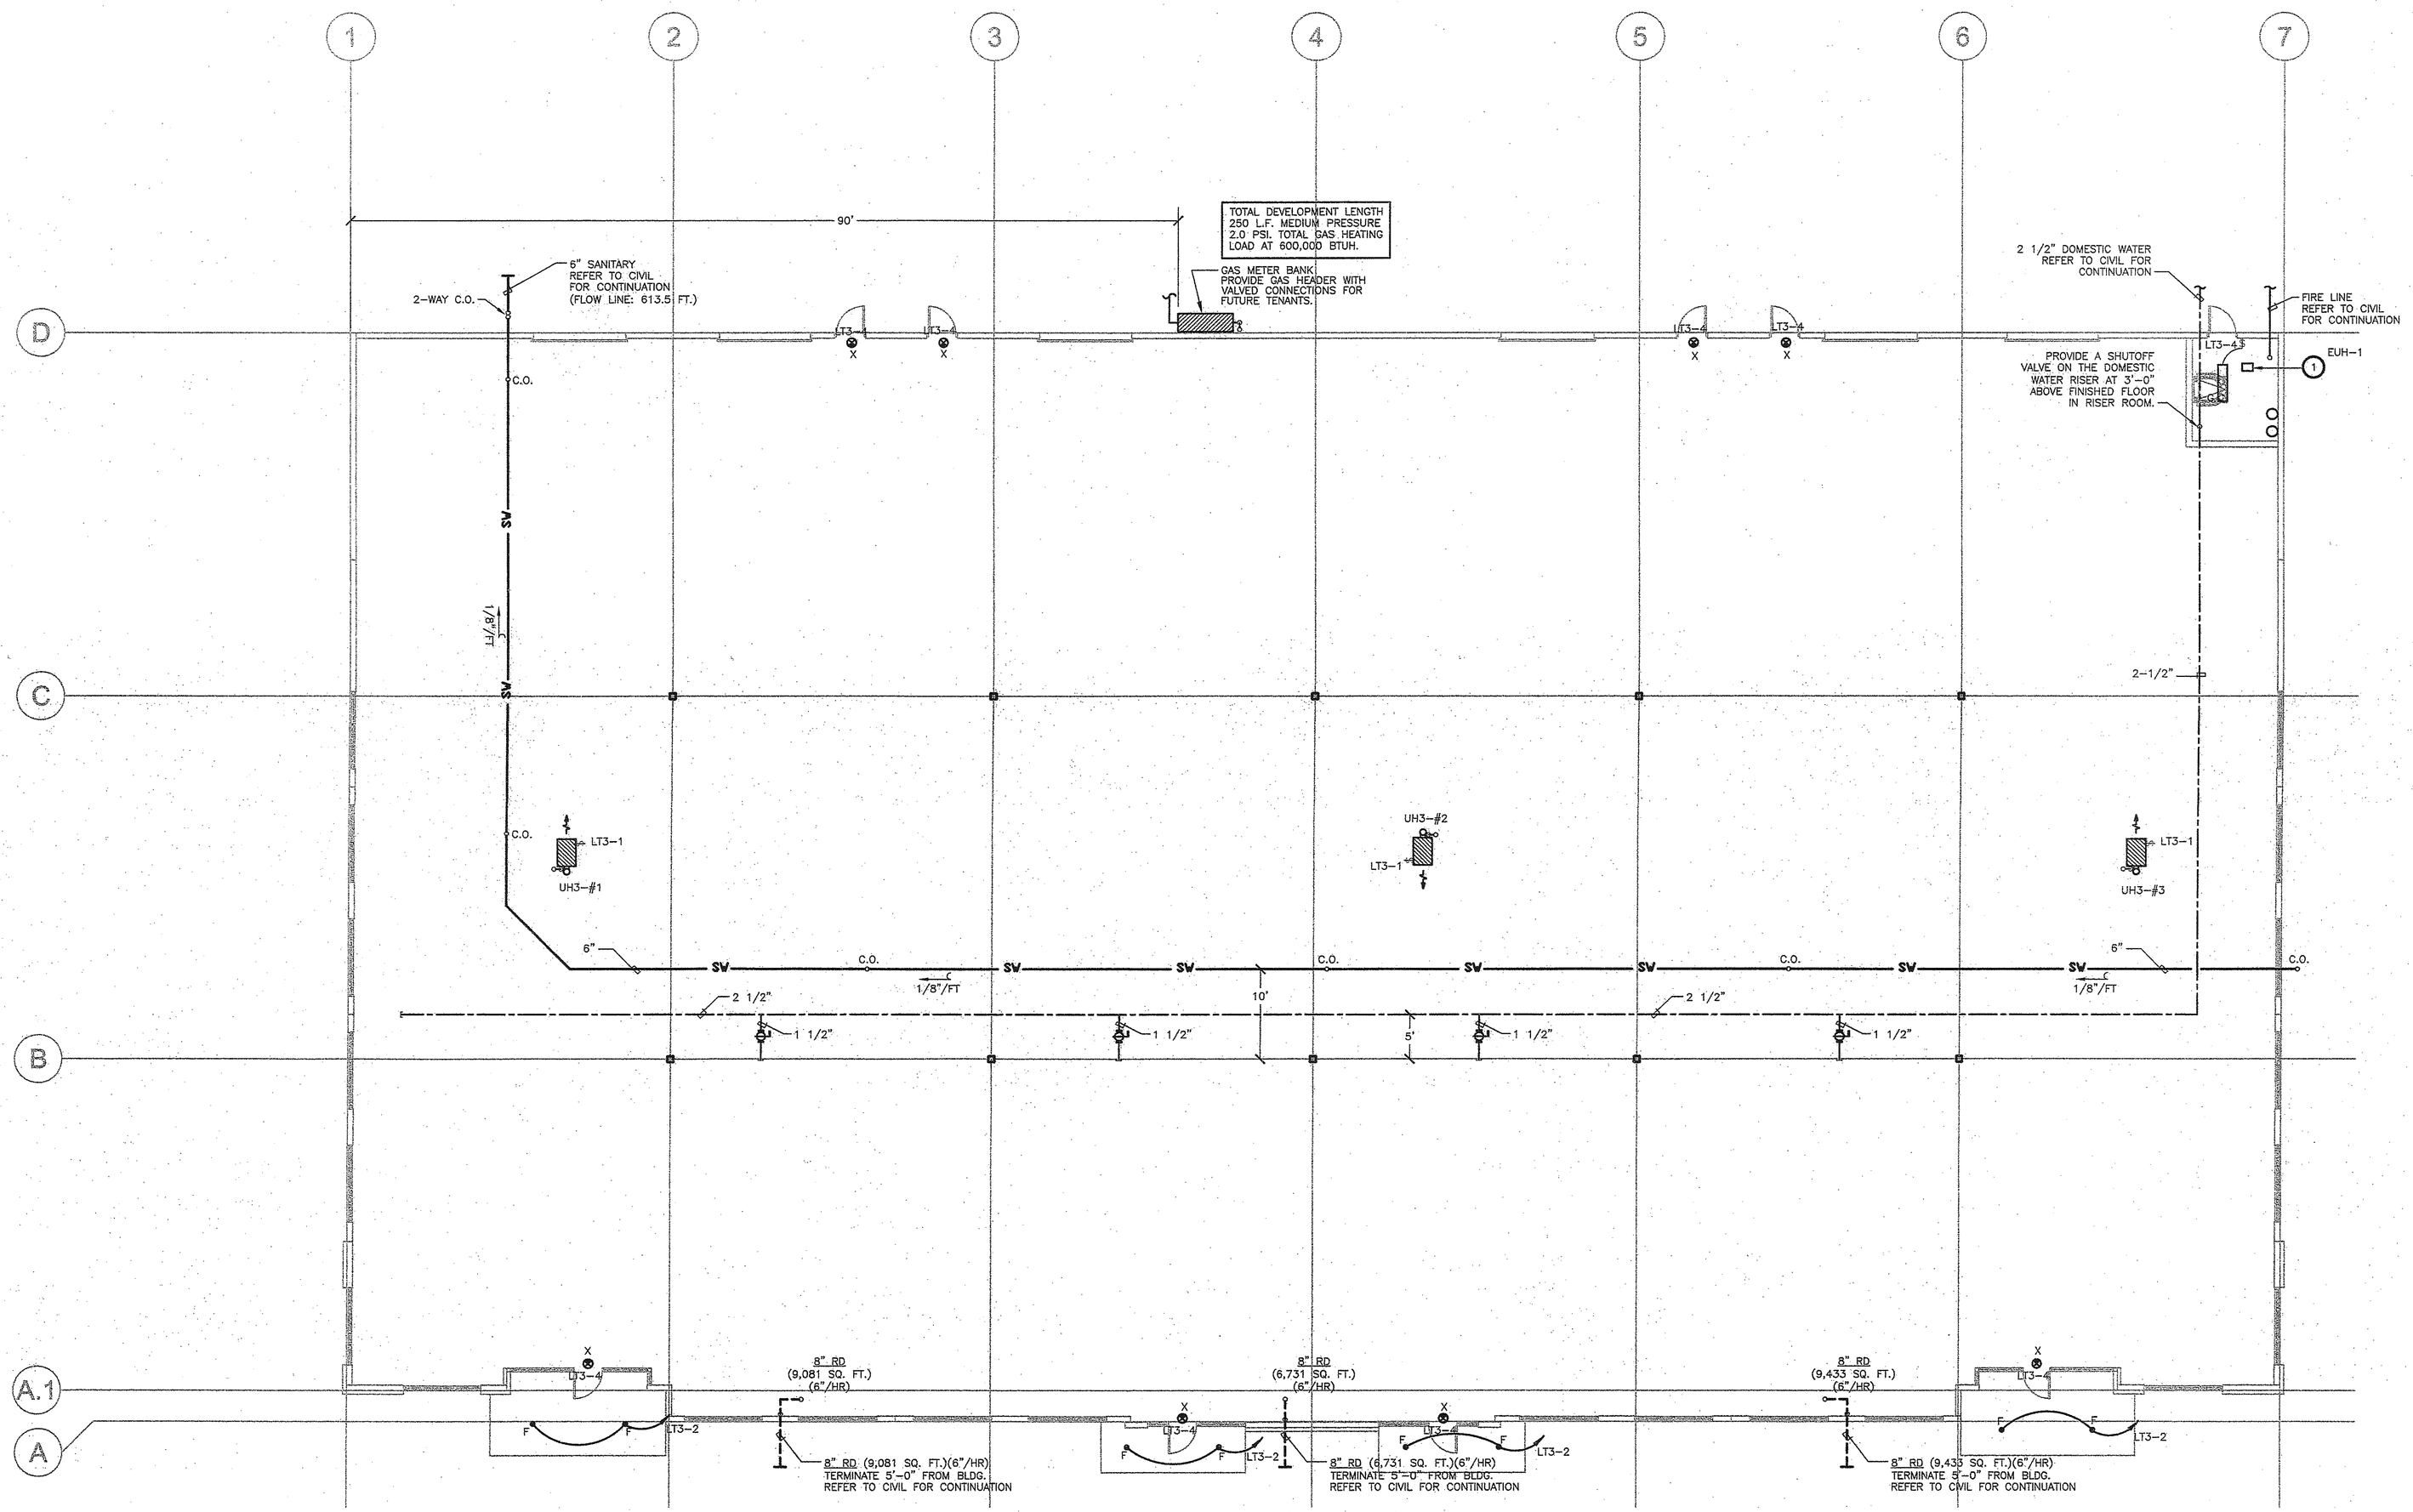

1 BUILDING 3 – PLUMBING PLAN

SCALE: 1/8"=1'-0"

GAS FIRED UNIT HEATERS								
DESIG.	CFM	INPUT MBH	OUTPUT MBH	FAN MOTOR HP	FAN RPM	FAN T.S.P.	FAN VOLTAGE	MANUFACTURER & MODEL
UH3-#1 THRU 3	2800	200,000	160,000	1/20	1050	NA	120	REZNOR MODEL FE-200
NOTES:								

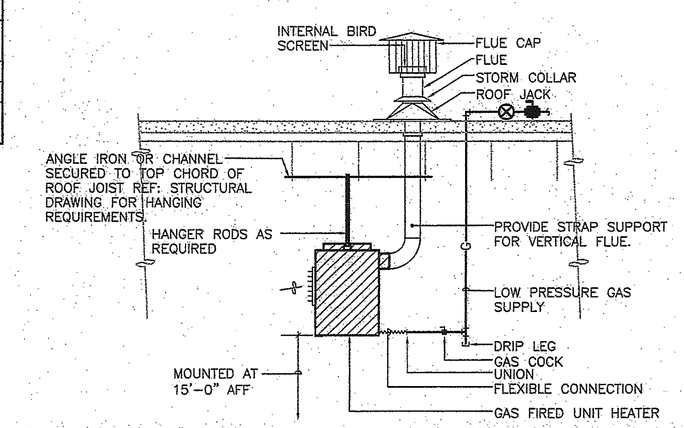

2 GAS FIRED UNIT HEATER DETAIL

SCALE: NO SCALE

KEYED NOTES:

1. ELECTRIC 5KW UNIT HEATER EQUAL TO MARKEL 5100 SERIES MODEL NUMBER P3P5105CA1N, 480V/3PH, 6.1 AMPS, 400 CFM, WITH: INTERNAL T-STAT, CELING MOUNTED BRACKET, FAN GUARD, DUST SHIELD. PROVIDE CIRCUIT HT3-8/8/10 WITH 3#12,1#12G,3/4"C.

GENERAL NOTES:

A. DOMESTIC WATER LINES ARE TO BE OVERHEAD ABOVE THE BOTTOM CHORD OF THE JOIST TO OPPOSITE ENDS OF THE BUILDING.

Purdy – McGuire
Mechanical – Electrical Engineers
4300 Sigma Road
Suite 200
Dallas, Texas 75244
Tel: 972/239-5357
Fax: 972/239-5231
www.purdy-mcguire.com

© 2006

PMI JOB NO. 06039.000

THIS DRAWING SHALL NOT BE REPRODUCED FOR ANY PROJECT OTHER THAN THE PROJECT NOTED IN THE TITLE BLOCK, WITHOUT THE WRITTEN CONSENT OF PURDY-McGUIRE, INC. DALLAS, TX

ALLIANCE ARCHITECTS
1600 N. Collins Blvd., Suite 1000
Richardson, Texas 75080
(972) 233-0400
Fax: (972) 233-2259

The Campus At
CASCADES
Phase One

JACKSON·SHAW

PROJECT RECORD DRAWINGS

KIP D. HANZLICK 66794 REGISTERED PROFESSIONAL ENGINEER
1-25-07

BUILDING 3 - PLUMBING PLAN

REVISIONS:

	CONSTRUCTION ISSUE 01/26/07

PROJECT NO.: 24235

MEP1.03

DATE: OCT. 26, 2006